
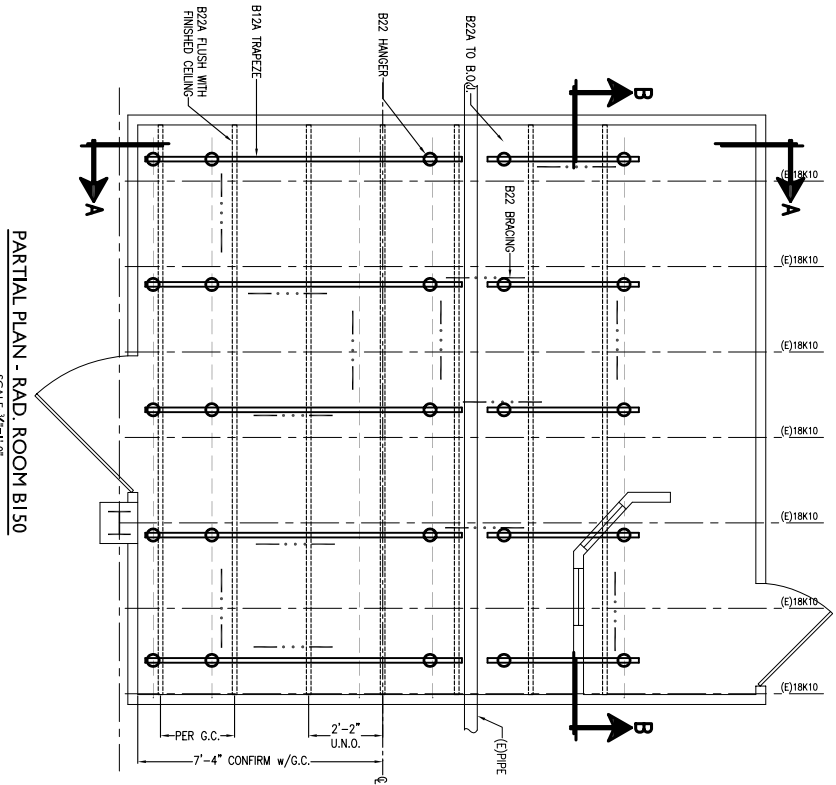
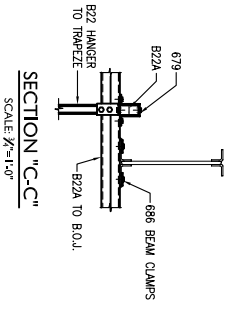
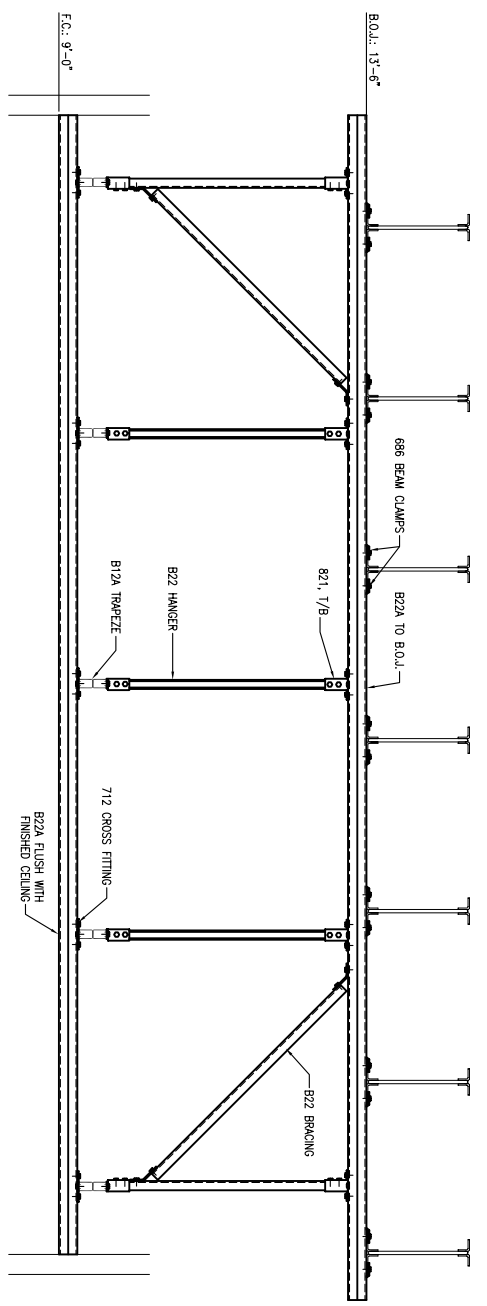


| REVISIONS | BY |
|-----------|----|
| AS-BUILT  | SC |
|           |    |
|           |    |
|           |    |
|           |    |

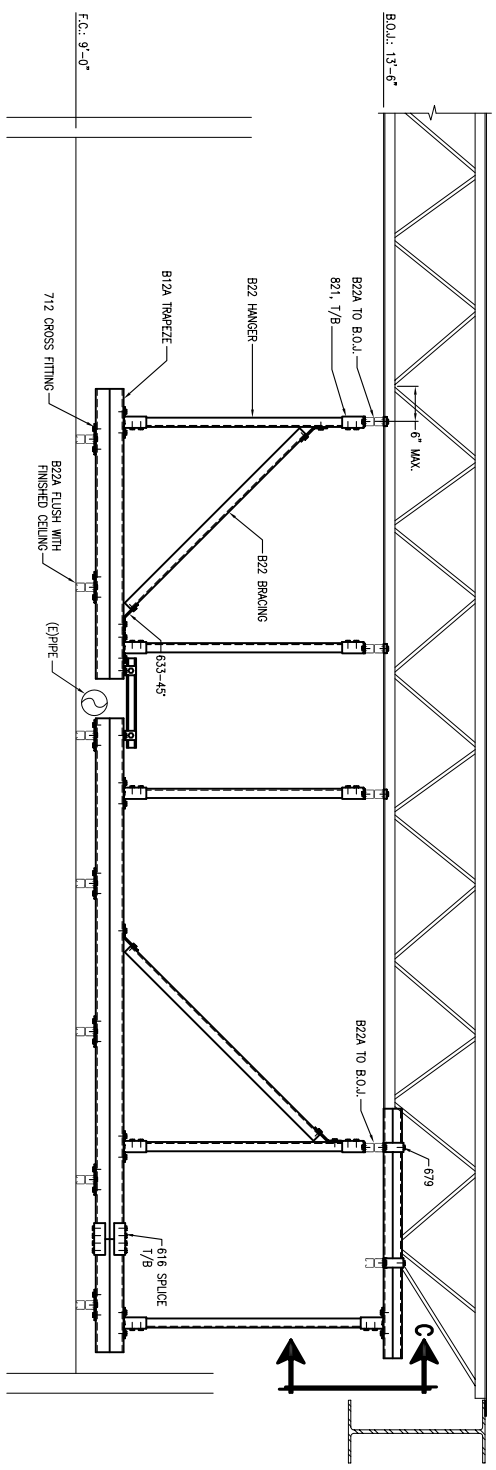

929 South High Street, Suite 167  
West Chester, PA 19382  
(484) 798-4098  
(610) 436-5651

WWW.STRUTCONSTRUCTION.COM

**Project:** JOHNS HOPKINS HOSPITAL - HARRIET LANE  
**Location:** BALTIMORE, MD  
**Contractor:**  
**Item:** RAD. ROOM B150 - EQUIPMENT SUPPORT STRUCTURE

|                   |          |
|-------------------|----------|
| <b>DRAWN BY</b>   | GRB      |
| <b>DATE</b>       | 12/15/06 |
| <b>SCALE</b>      | NOTED    |
| <b>JOB NUMBER</b> |          |
| <b>SHEET</b>      | 1        |